



Audio Visual Low Level Design Cover Sheet & Drawing Register

Client: Blackmores Limited

Project: V4 Blackmores General Meeting and Boardroom POC

Types: Audio Visual Schematic System

LINES AND CABLE IDS

C001
8723 CONTROL CABLE
D001
CAT 6A ETHERNET CABLE
W001
CRESNET CABLE
V001
CAT 6A VIDEO TRANSMISSION
I001
COMPONENT CABLE
J001
COMPOSITE CABLE
F001
HEARING LOOP FEEDER CABLE
H001
DIGITAL (HDMI/DVI/DISPLAY PORT) CABLE
T001
RG8U CABLE
B001
RG11 CABLE
G001
RGBHV / 5-CORE MINI COAXIAL CABLE
S001
FIGURE 8 SPEAKER CABLE
Q001
S-VIDEO CABLE
A001
8723 AUDIO CABLE
U2001
USB 2.0 CABLE
U3001
USB 3.0 CABLE
L001
HEARING LOOP TAPE
P001
LOW VOLTAGE POWER CABLE
M001
MULTI-CORE MICROPHONE CABLE
R001
RG6 CABLE
UC001
USB C CABLE
N001
SINGLE-MODE FIBRE CABLE
O001
MULTI-MODE FIBRE CABLE
Y001
PROPRIETARY CABLE
IC001
RACK INTERCONNECT CABLE

LOCATION COLOURS

WALL	TABLE
CEILING	LECTERN
FLOOR	MOBILE
RACK	CREDENZA
FREE STAND	BIO BOX

COMMS PORTS

AV LAN	BMS LAN
L #	L #
CLIENT LAN	DANTE/AES LAN
L #	L #
PSTN LINE	SVSI/NVX LAN
P #	L #

CONTROL PORTS

SERIAL (232, 485)
INFRARED
RELAY
I/O
PROPRIETARY LINK

GENERAL ARRANGEMENT SYMBOLS

SINGLE SWITCHED GENERAL POWER OUTLET
DOUBLE SWITCHED GENERAL POWER OUTLET
SINGLE CAT 6 DATA OUTLET
DOUBLE CAT 6 DATA OUTLET
MATV OUTLET
65MM CORE HOLE
AV RACK
FLUSH MOUNTED CEILING SPEAKER
SURFACE MOUNTED SPEAKER
DATA PROJECTOR
WALL MOUNTED LCD DISPLAY
CEILING MOUNTED LCD DISPLAY
TROLLEY MOUNTED LCD DISPLAY
MOTORISED PROJECTION SCREEN
DESKTOP MOUNTED DISPLAY
PTZ CAMERA MOUNT
TABLE BOX INPUT
FLOOR BOX INPUT/OUTPUT
INPUT PLATE
TOUCH CONTROL INTERFACE
ROOM BOOKING PANEL
CONTROL KEYPAD
INFRARED HEARING AUGMENTATION
ANTENNA
GOOSENECK MICROPHONE
BOUNDARY MICROPHONE
CEILING ACCESS PANEL
CEILING MICROPHONE
CEILING MICROPHONE ARRAY

DRAWING SET REGISTER			
Drawing No	Description	Rev	Note
PAVS-AV-BGMD-LD-100	Cover Sheet & Drawing Register	G	
PAVS-AV-BGMD-LD-101	Scope of Works	A	
PAVS-AV-BGMD-LD-102	General Meeting Rooms with Canvas	B	
PAVS-AV-BGMD-LD-103	General Meeting Rooms BYOD	A	
PAVS-AV-BGMD-LD-104	General Meeting Rooms Interactive	B	
PAVS-AV-BGMD-LD-105	Boardroom	B	
PAVS-AV-BGMD-LD-106	Reception	C	
PAVS-AV-BGMD-LD-107	Product Display	B	
PAVS-AV-BGMD-LD-108	Meet & Eat	D	
PAVS-AV-BGMD-LD-109	Comms Room - AV Rack	A	

NOTES:
THE INFORMATION CONTAINED IN THIS DOCUMENT IS PROPRIETARY TO PRO AV SOLUTIONS (NSW) THIS DOCUMENT IS PREPARED FOR A SPECIFIC SITE AND INCORPORATES CALCULATIONS BASED ON DATA AVAILABLE AT THIS TIME. BY ACCEPTING AND USING THIS DOCUMENT, THE RECIPIENT AGREES TO PROTECT ITS CONTENTS FROM FURTHER DISSEMINATION, OTHER THAN THAT WITHIN THE ORGANIZATION NECESSARY TO EVALUATE SUCH SPECIFICATION) WITHOUT THE WRITTEN PERMISSION OF PRO AV SOLUTIONS (NSW) THE CONTENTS OF THIS DOCUMENT ARE NOT TO BE REPRODUCED OR COPIED IN WHOLE OR IN PART WITHOUT THE WRITTEN PERMISSION OF PRO AV SOLUTIONS (NSW).

G	22/04/22	For Construction Issue	BM
F	21/04/22	For Construction Issue	KB
E	04/04/22	For Construction Issue	KB
D	28/03/22	For Construction Issue	KB
C	22/03/22	For Construction Issue	KB
B	15/03/22	For Construction Issue	KB
A	08/03/22	For Construction Issue	KB
REV	DATE	REVISION DESCRIPTION	DRAWN

STATUS:
FOR CONSTRUCTION



Unit 8, 25 Frenchs Forest Rd
Frenchs Forest
NSW 2086

Ph: (02) 8978 1700
Fax: (02) 9907 2077
www.proAVsolutions.com.au

CLIENT:
BLACKMORES LIMITED

BLACKMORES®

PROJECT:
V4 Blackmores General Meeting and Boardroom
POC & Reception Wall

TITLE:
Cover Sheet & Drawing Register

SHEET SIZE: A3	SCALE: N/A	DRAWN: KB	CHECKED: VG
-------------------	---------------	--------------	----------------

JOB NO.:
1448 & 1466

DRAWING NO.: PAVS-AV-BGMD-LD-100	REV: G
-------------------------------------	------------------

Scope of Works:

Project 1448

General meeting rooms scope (Canvas, Interactive & BYOD):

A Crestron soundbar Mircsoft Teams solutions with an associated 65" display forms the basis of the general meeting rooms. An Airmedia player is provided for both wireless presentation and room dashboard signage. Workflow for dashboard / far end view / presentation content will be completed via Teams in built 'People. People and content, content' button, provided on the Teams UI. A room booking touchpanel and room sign are provided externally to the room, along with an occupancy sensor for room occupancy detection and room analytics and control.

There are 3 variations of the room type including:

- Addition of a whiteboard capture camera (Canvas)
- Addition of a touch display for Microsoft Teams Whiteboarding (Interactive)
- Addition of a BX BYOM system (BYOD)

Room workflow:

When occupancy is detected, the system will switch on and default display the signage dashboard provided by the Airmedia player. If not booked the room booking system should indicate room is occupied.

Once a call is activated, the user will then use the 'people, People and content. content' button to select the desired call in/out and local display.

- In rooms that have a whiteboard camera, the client can select this presentation content via the Teams UI.
- In rooms with a touch display, a native Teams whiteboarding session can be activated by an attendee in the Teams meeting.

Direct mark-ups can then be completed via the local touch display.

- In rooms that have BYOM functionality, a laptop can be connected via HDMI and USB to enable a BYOM meeting to be driven by a local laptop, utilising the camera, microphone and speaker from the inbuilt room system

Boardroom scope:

A Crestron Integrated Microsoft Teams solutions with an associated 98" display forms the basis of the Boardroom.

An Airmedia player is provided for both wireless presentation and room dashboard signage. Workflow for dashboard / far end view / presentation content

will be completed via Teams in built 'People. People and content, content' button, provided on the Teams UI.

Lighting control will be available via the control page flip on the MTR Touchpanel. Lighting interface is to be provided by others

A room booking touchpanel and room sign are provided externally to the room, along with two occupancy sensors for room occupancy detection and room

analytics and control. Microphone audio is to be utilised as a secondary occupancy detection method also.

A total of 6 Table boxes will be provided:

3 table boxes will include a HDMI and 3 boxes will include USB-C, for wired content connection

In addition, each table box will have a mains power socket, USB-A charge socket and network connection.

A HDMI input plate is provided at the front of the room for wired content connectivity.

An MXA-910 ceiling microphone with associated ceiling speakers will provide audio for content and conferencing audio.

IR Hearing augmentation is provided for hearing impaired.

Room workflow:

When occupancy is detected, the system will switch on and default display the signage dashboard provided by the Airmedia player. If not booked the room booking system should indicate room is occupied.

Once a call is activated, the user will then use the 'people, People and content. content' button to select the desired call in/out and local display.

- In rooms that have a whiteboard camera, the client can select this presentation content via the Teams UI.
- In rooms with a touch display, a native Teams whiteboarding session can be activated by an attendee in the Teams meeting.

Direct mark-ups can then be completed via the local touch display.

- In rooms that have BYOM functionality, a laptop can be connected via HDMI and USB to enable a BYOM meeting to be driven by a local laptop, utilising the camera, microphone and speaker from the inbuilt room system

Project 1466

Reception scope:

The reception area is mainly up of three separate systems:

Cafe 'Menu' Boards:

The Cafe menu boards consist of 2 Landscape mounted displays with associated signage player, to enable simple management of the cafe menu day to day.

Product Orientation Area (Product Display):

The product orientation area consists of a Touch interactive display and associated touch-enabled signage player.

Main LED wall display (Meet & Eat):

The main reception LED wall is the centre piece of the reception area to create an eye-catching focal point for visitors attending site.

The LED wall will have a signage player attached for everyday signage media.

Local HDMI presentation input provided, with final location in LED wall joinery TBC.

Audio breakout via ceiling speakers to local reception provided. Wireless microphone including 2 x lapel mics and 2 x handheld mics, provided with receiver to be installed central to reception / flexi space, to allow for use in future Flexi Space system

5" Touchpanel to be located at the reception desk for AV source and volume control.

All media content is to be provided by the client

NOTES:

THE INFORMATION CONTAINED IN THIS DOCUMENT IS PROPRIETARY TO PRO AV SOLUTIONS (NSW). THIS DOCUMENT IS PREPARED FOR A SPECIFIC SITE AND INCORPORATES CALCULATIONS BASED ON DATA AVAILABLE AT THIS TIME. BY ACCEPTING AND USING THIS DOCUMENT, THE RECIPIENT AGREES TO PROTECT ITS CONTENTS FROM FURTHER DISSEMINATION, OTHER THAN THAT WITHIN THE ORGANIZATION NECESSARY TO EVALUATE SUCH SPECIFICATION, WITHOUT THE WRITTEN PERMISSION OF PRO AV SOLUTIONS (NSW). THE CONTENTS OF THIS DOCUMENT ARE NOT TO BE REPRODUCED OR COPIED IN WHOLE OR IN PART WITHOUT THE WRITTEN PERMISSION OF PRO AV SOLUTIONS (NSW).

A	08/03/22	For Construction Issue	KB
REV	DATE	REVISION DESCRIPTION	DRAWN

STATUS:

FOR CONSTRUCTION



Unit 8, 25 Frenchs Forest Rd
Frenchs Forest
NSW 2086
Ph: (02) 8978 1700
Fax: (02) 9907 2077
www.proAVsolutions.com.au

CLIENT:

BLACKMORES LIMITED

BLACKMORES®

PROJECT:

V4 Blackmores General Meeting and Boardroom
POC & Reception Wall

TITLE:

Scope of Works

SHEET SIZE:	SCALE:	DRAWN:	CHECKED:
A3	N/A	KB	VG

JOB NO.:

1448 & 1466


DRAWING NO.:

PAVS-AV-BGMD-LD-101

REV:

A

Blackmores Limited
General Meeting Rooms with Canvas

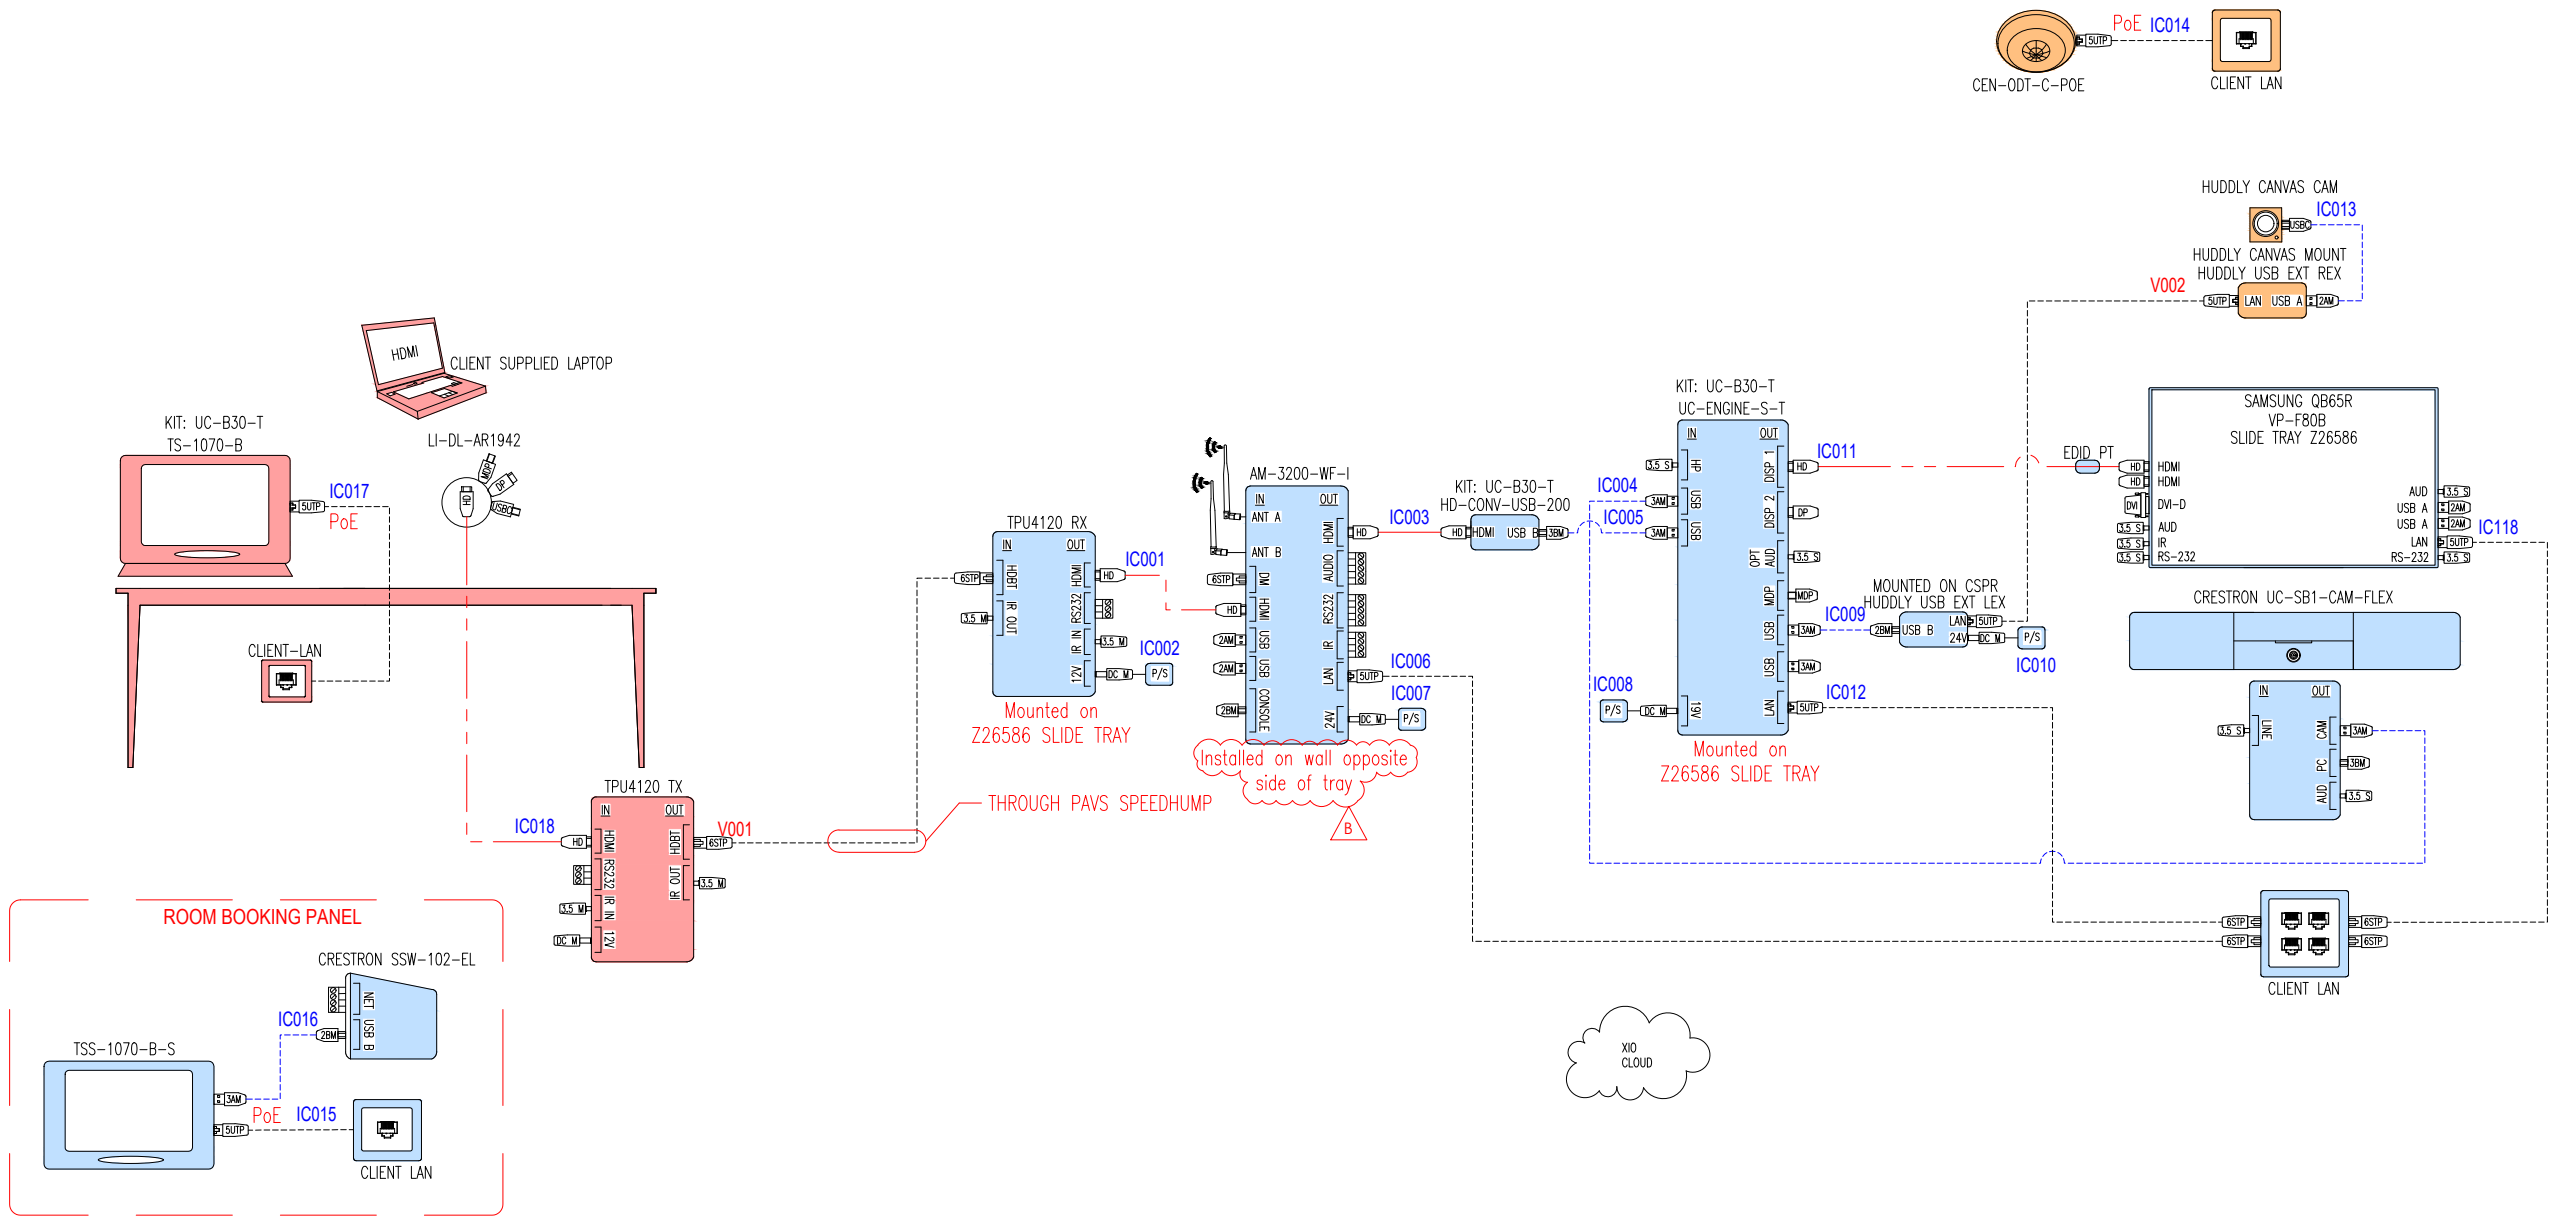

NOTES:
THE INFORMATION CONTAINED IN THIS DOCUMENT IS PROPRIETARY TO PRO AV SOLUTIONS (NSW) THIS DOCUMENT IS PREPARED FOR A SPECIFIC SITE AND INCORPORATES CALCULATIONS BASED ON DATA AVAILABLE AT THIS TIME. BY ACCEPTING AND USING THIS DOCUMENT, THE RECIPIENT AGREES TO PROTECT ITS CONTENTS FROM FURTHER DISSEMINATION, OTHER THAN THAT WITHIN THE ORGANIZATION NECESSARY TO EVALUATE SUCH SPECIFICATION) WITHOUT THE WRITTEN PERMISSION OF PRO AV SOLUTIONS (NSW) THE CONTENTS OF THIS DOCUMENT ARE NOT TO BE REPRODUCED OR COPIED IN WHOLE OR IN PART WITHOUT THE WRITTEN PERMISSION OF PRO AV SOLUTIONS (NSW).

B	22/04/22	For Construction Issue	BM
A	08/03/22	For Construction Issue	KB
REV	DATE	REVISION DESCRIPTION	DRAWN

STATUS:
FOR CONSTRUCTION



Unit 8, 25 Frenchs Forest Rd
Frenchs Forest
NSW 2086
Ph: (02) 8978 1700
Fax: (02) 9907 2077
www.proAVsolutions.com.au

CLIENT:
BLACKMORES LIMITED

BLACKMORES®

PROJECT:
V4 Blackmores General Meeting and Boardroom
POC & Reception Wall

TITLE:
General Meeting Rooms with
Canvas


SHEET SIZE: A3	SCALE: N/A	DRAWN: KB	CHECKED: VG
-------------------	---------------	--------------	----------------

JOB NO.:
1448 & 1466

DRAWING NO.: PAVS-AV-BGMD-LD-102	REV: B
-------------------------------------	-----------

NOTES:

THE INFORMATION CONTAINED IN THIS DOCUMENT IS PROPRIETARY TO PRO AV SOLUTIONS (NSW). THIS DOCUMENT IS PREPARED FOR THE RECIPIENT'S USE AND INCORPORATES CALCULATIONS BASED ON DATA AVAILABLE AT THIS TIME. BY ACCEPTING AND USING THIS DOCUMENT, THE RECIPIENT AGREES TO PROTECT ITS CONTENTS FROM FURTHER DISSEMINATION, (OTHER THAN THAT WITHIN THE DISSEMINATION NECESSARY TO EVALUATE SUCH SPECIFICATION) WITHOUT THE WRITTEN PERMISSION OF PRO AV SOLUTIONS (NSW). THE CONTENTS OF THIS DOCUMENT ARE NOT TO BE REPRODUCED OR COPIED IN WHOLE OR IN PART WITHOUT THE WRITTEN PERMISSION OF PRO AV SOLUTIONS (NSW).

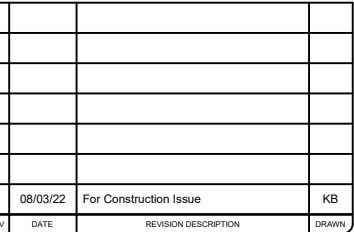

 Unit 8, 25 Frenchs Forest Rd
Frenchs Forest
NSW 2086


Ph: (02) 8978 1700
Fax: (02) 9907 2077
www.proAVsolutions.com.au

experience excellence

TITLE: General Meeting Rooms BYOD			
HEET SIZE:	SCALE:	DRAWN:	CHECKED:
A3	N/A	KB	VG
DB NO.:			
1448 & 1466			
DRAWING NO.:			REV:
PAVS-AV-BGMD-LD-103			A

Blackmores Limited
General Meeting Rooms Interactive

NOTES:
THE INFORMATION CONTAINED IN THIS DOCUMENT IS PROPRIETARY TO PRO AV SOLUTIONS (NSW) THIS DOCUMENT IS PREPARED FOR A SPECIFIC SITE AND INCORPORATES CALCULATIONS BASED ON DATA AVAILABLE AT THIS TIME. BY ACCEPTING AND USING THIS DOCUMENT, THE RECIPIENT AGREES TO PROTECT ITS CONTENTS FROM FURTHER DISSEMINATION, OTHER THAN THAT WITHIN THE ORGANIZATION NECESSARY TO EVALUATE SUCH SPECIFICATION) WITHOUT THE WRITTEN PERMISSION OF PRO AV SOLUTIONS (NSW) THE CONTENTS OF THIS DOCUMENT ARE NOT TO BE REPRODUCED OR COPIED IN WHOLE OR IN PART WITHOUT THE WRITTEN PERMISSION OF PRO AV SOLUTIONS (NSW).

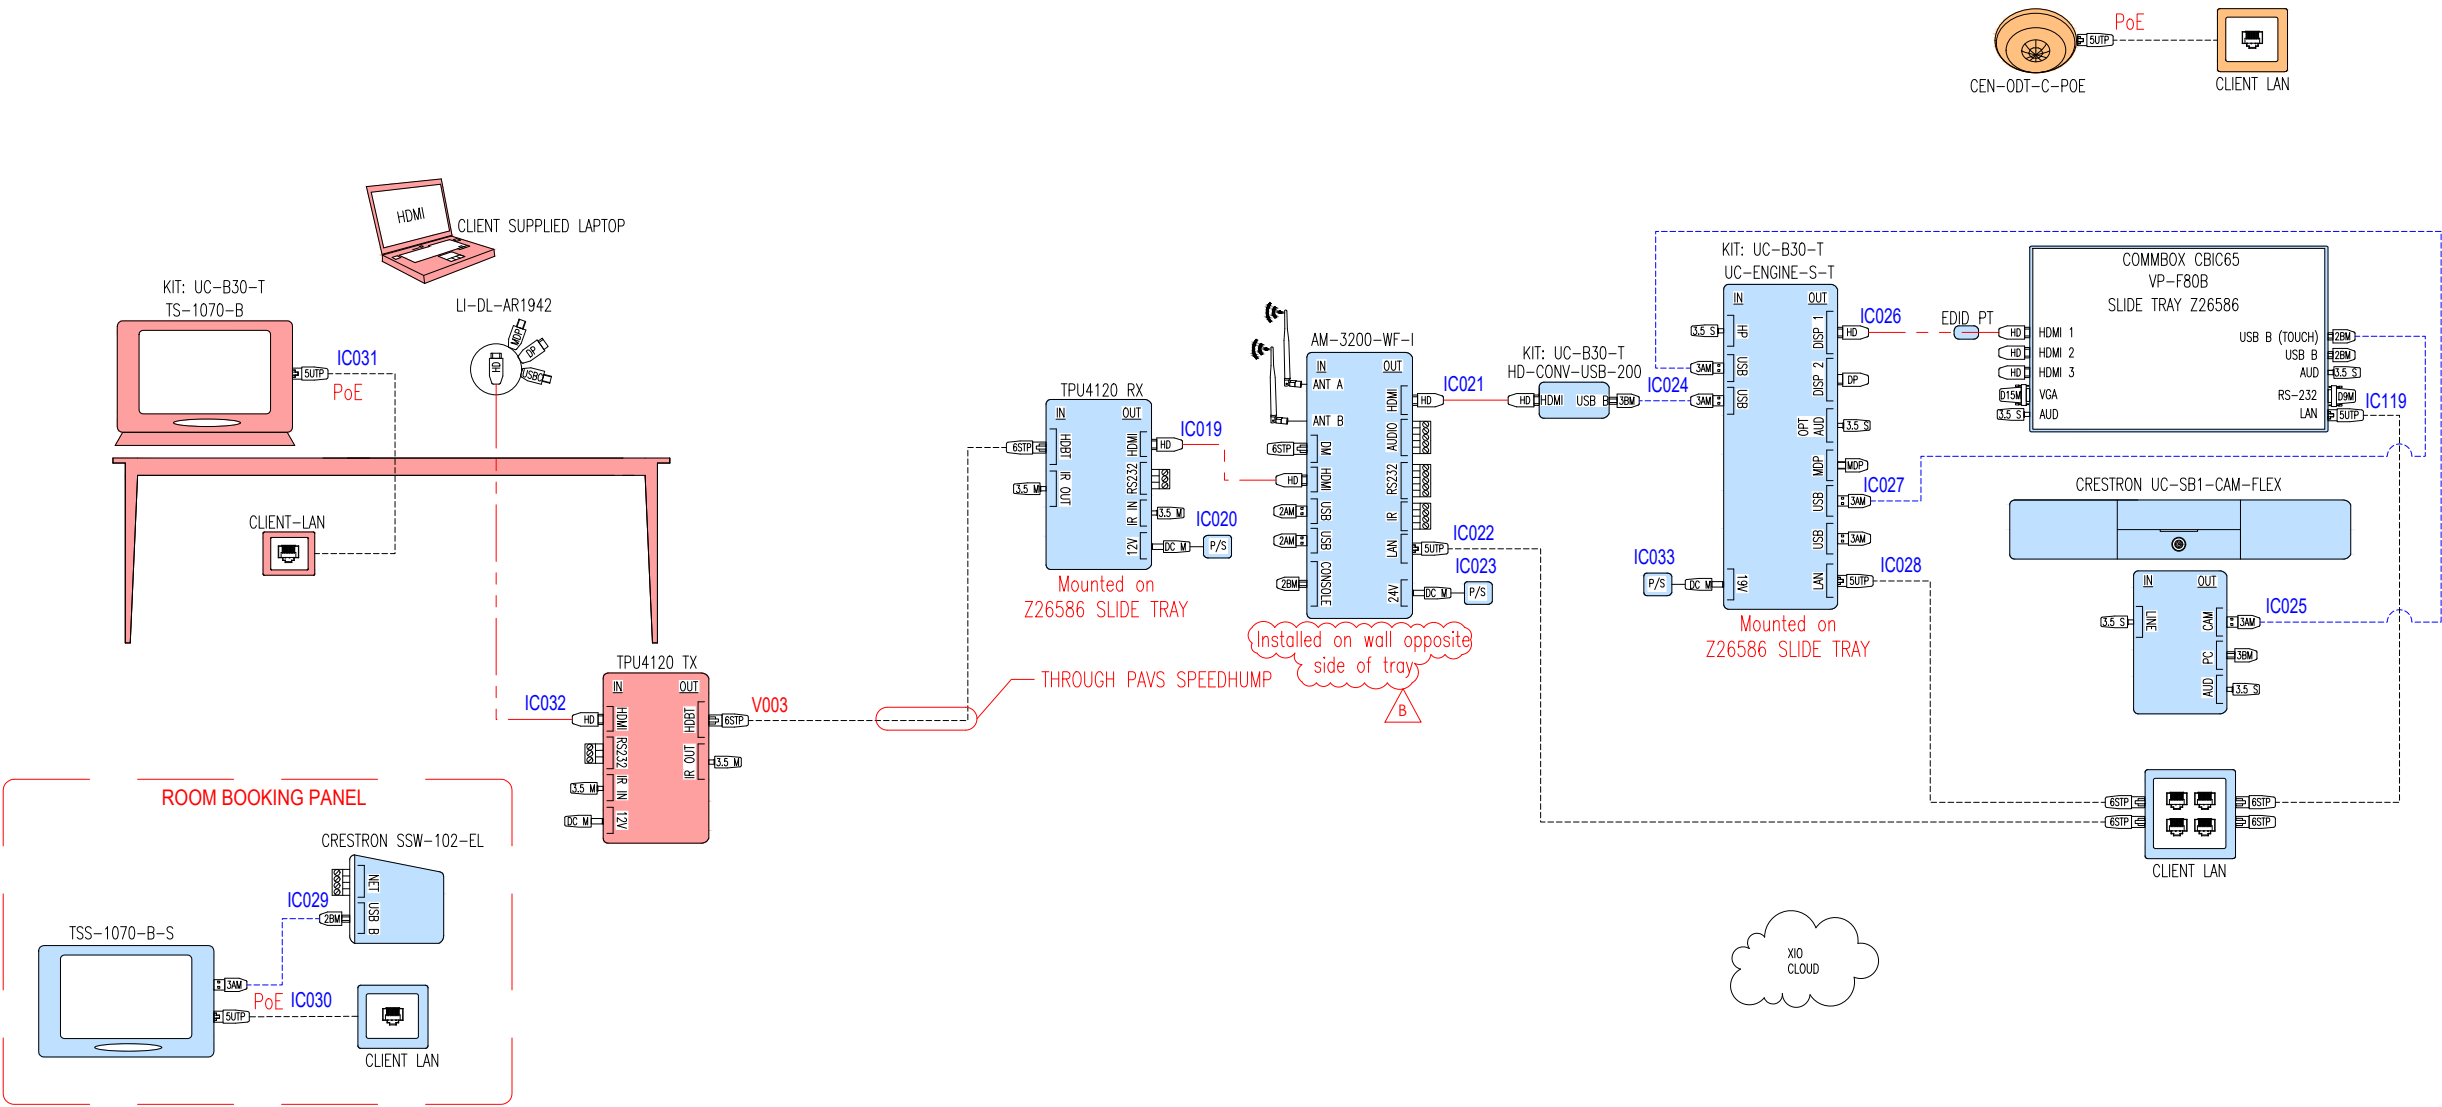

B	22/04/22	For Construction Issue	BM
A	08/03/22	For Construction Issue	KB
REV	DATE	REVISION DESCRIPTION	DRAWN

STATUS:
FOR CONSTRUCTION



Unit 8, 25 Frenchs Forest Rd
Frenchs Forest
NSW 2086

Ph: (02) 8978 1700
Fax: (02) 9907 2077
www.proAVsolutions.com.au

CLIENT:
BLACKMORES LIMITED

BLACKMORES

PROJECT:
V4 Blackmores General Meeting and Boardroom
POC & Reception Wall

TITLE:
General Meeting Rooms Interactive

SHEET SIZE: A3	SCALE: N/A	DRAWN: KB	CHECKED: VG
-------------------	---------------	--------------	----------------


JOB NO.:
1448 & 1466

DRAWING NO.:
PAVS-AV-BGMD-LD-104

REV:
B

NOTES:

THE INFORMATION CONTAINED IN THIS DOCUMENT IS PROPRIETARY TO PRO AV SOLUTIONS (NSW). THIS DOCUMENT IS PREPARED FOR THE RECIPIENT'S USE AND INCORPORATES CALCULATIONS BASED ON DATA AVAILABLE AT THIS TIME. BY ACCEPTING AND USING THIS DOCUMENT, THE RECIPIENT AGREES TO PROTECT ITS CONTENTS FROM FURTHER DISSEMINATION, (OTHER THAN THAT WITHIN THE DISSEMINATION NECESSARY TO EVALUATE SUCH SPECIFICATION) WITHOUT THE WRITTEN PERMISSION OF PRO AV SOLUTIONS (NSW). THE CONTENTS OF THIS DOCUMENT ARE NOT TO BE REPRODUCED OR COPIED IN WHOLE OR IN PART WITHOUT THE WRITTEN PERMISSION OF PRO AV SOLUTIONS (NSW).

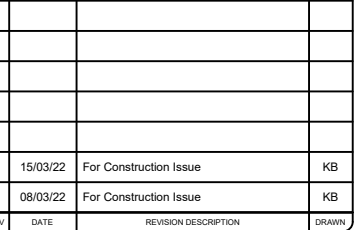

 Unit 8, 25 Frenchs Forest Rd
Frenchs Forest
NSW 2086


Ph: (02) 8978 1700
Fax: (02) 9907 2077
www.proAVsolutions.com.au

TITLE:
Boardroom

DRAWING NO.:	REV:
PAVS-AV-BGMD-LD-105	B

Blackmores Limited Reception

NOTES:
THE INFORMATION CONTAINED IN THIS DOCUMENT IS PROPRIETARY TO PRO AV SOLUTIONS (NSW) THIS DOCUMENT IS PREPARED FOR A SPECIFIC SITE AND INCORPORATES CALCULATIONS BASED ON DATA AVAILABLE AT THIS TIME. BY ACCEPTING AND USING THIS DOCUMENT, THE RECIPIENT AGREES TO PROTECT ITS CONTENTS FROM FURTHER DISSEMINATION, OTHER THAN THAT WITHIN THE ORGANIZATION NECESSARY TO EVALUATE SUCH SPECIFICATION WITHOUT THE WRITTEN PERMISSION OF PRO AV SOLUTIONS (NSW) THE CONTENTS OF THIS DOCUMENT ARE NOT TO BE REPRODUCED OR COPIED IN WHOLE OR IN PART WITHOUT THE WRITTEN PERMISSION OF PRO AV SOLUTIONS (NSW).

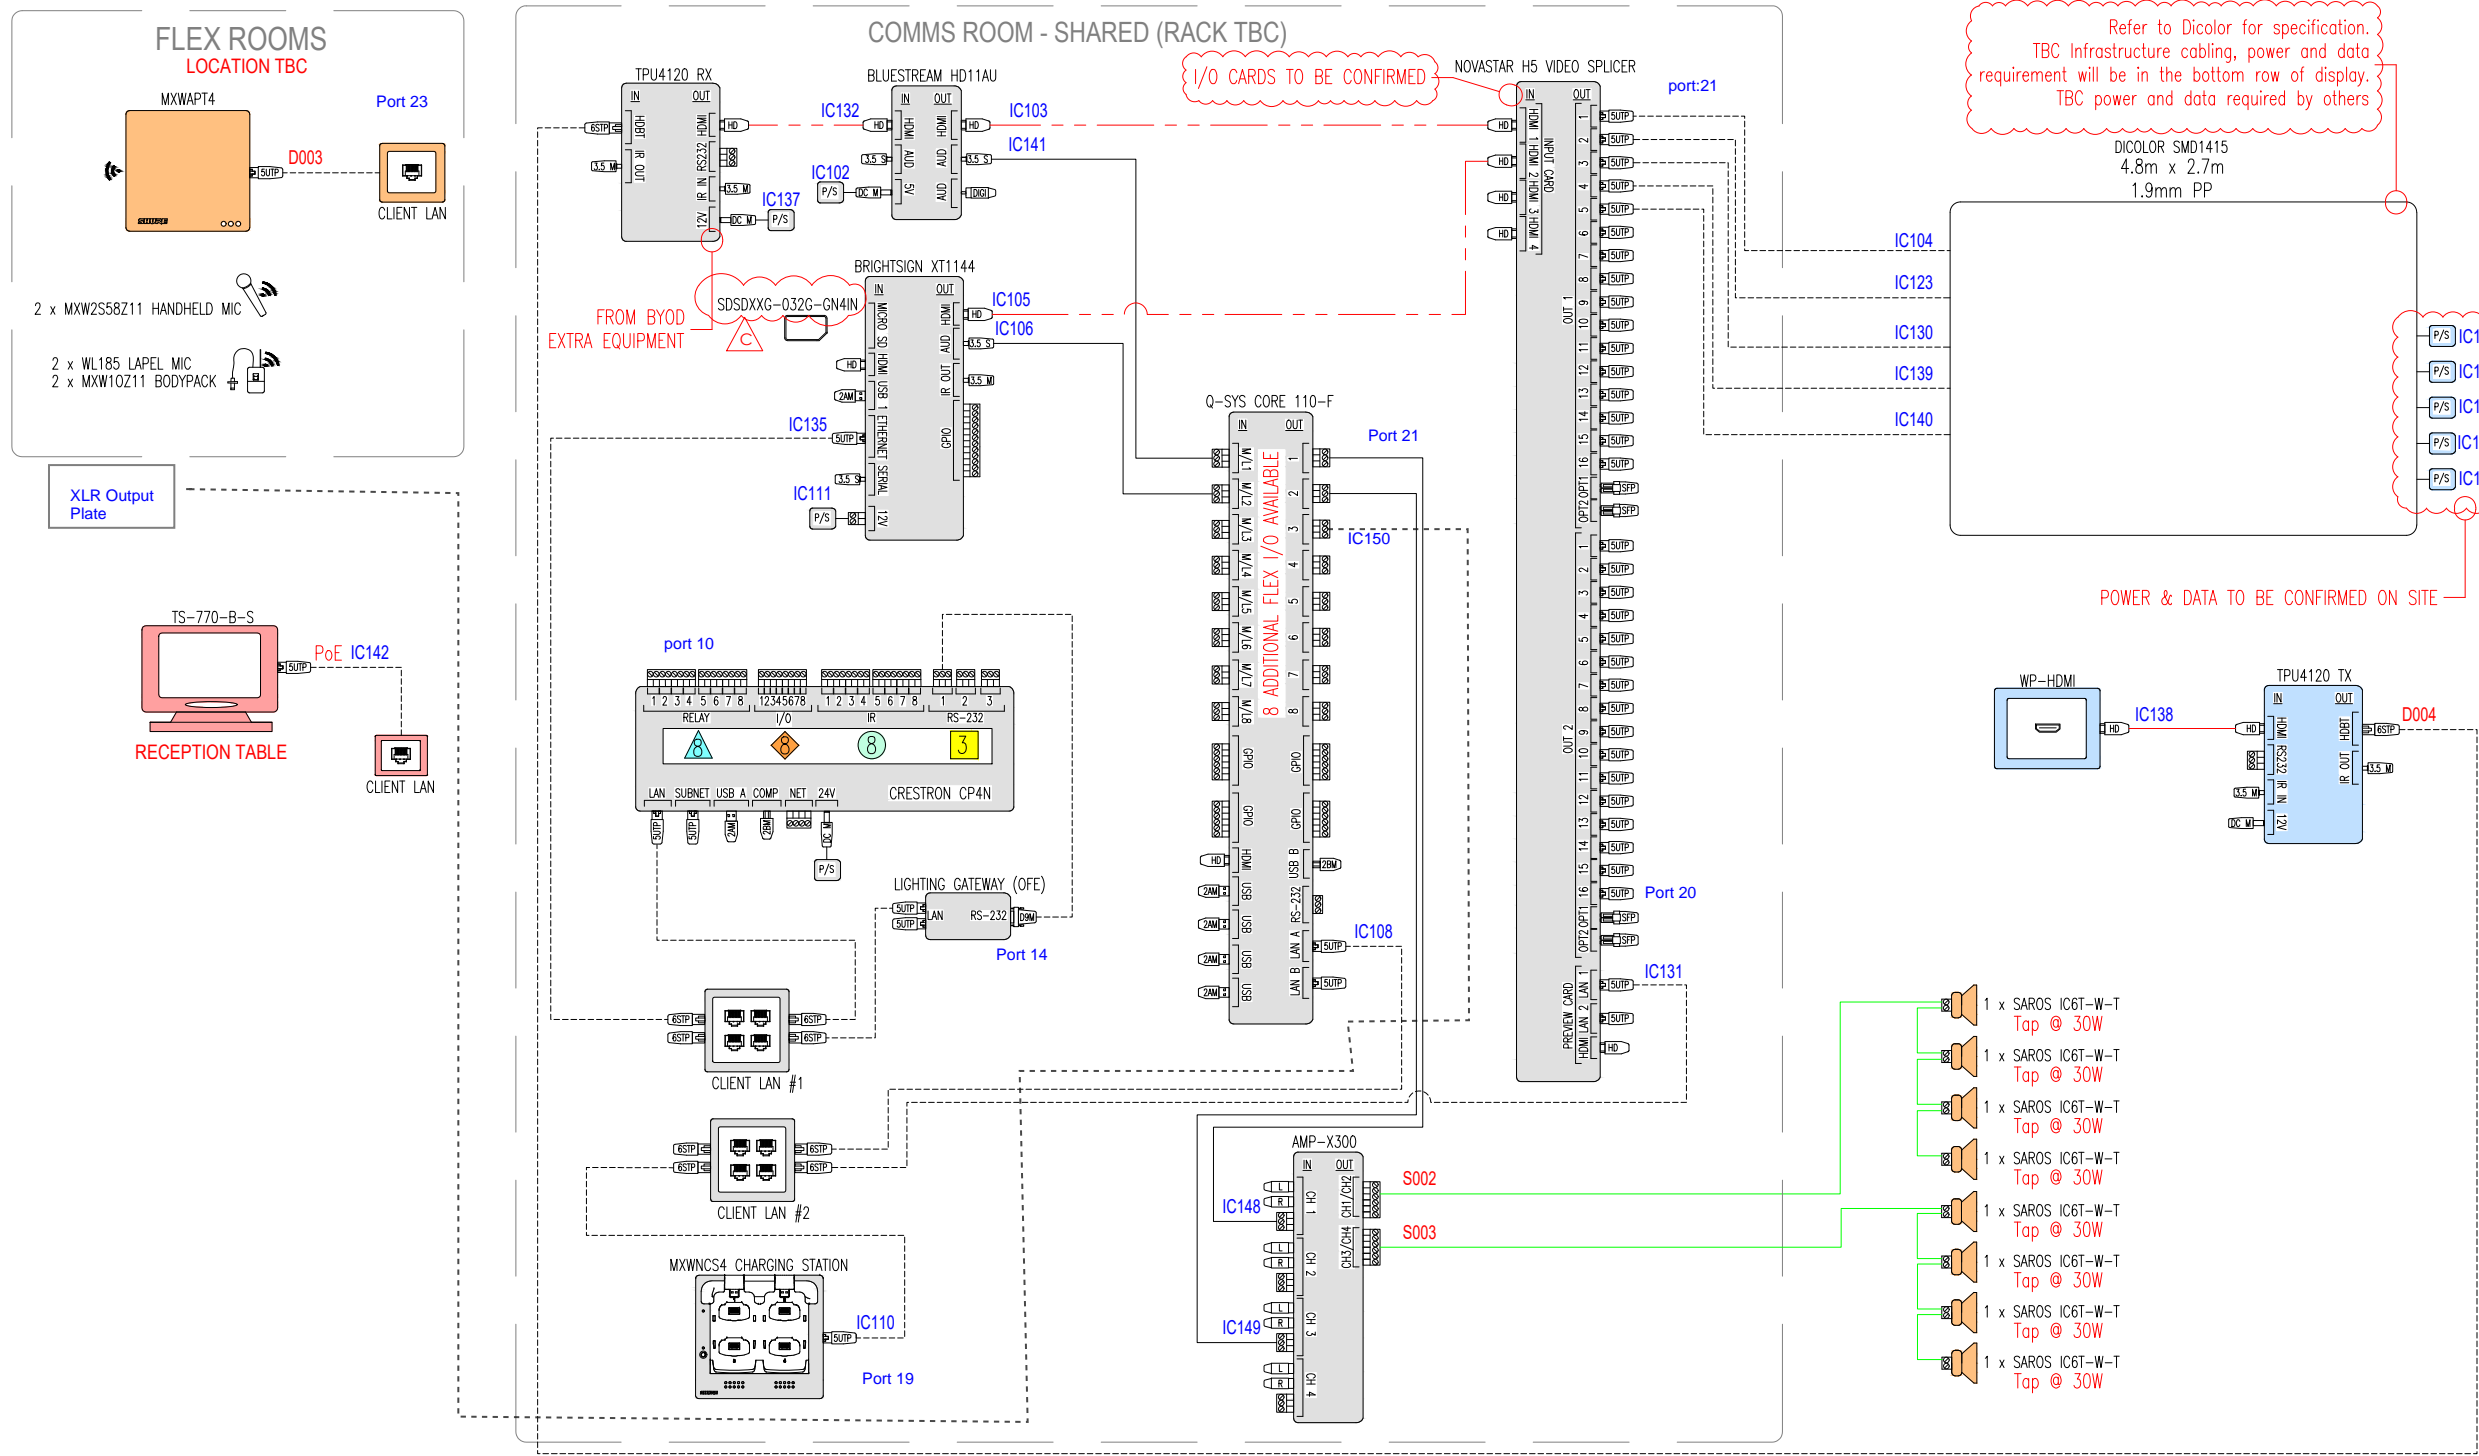

STATUS:
FOR CONSTRUCTION

PRO AV SOLUTIONS
Unit 8, 25 Frenchs Forest Rd
Frenchs Forest
NSW 2086
Ph: (02) 8978 1700
Fax: (02) 9907 2077
www.proAVsolutions.com.au

CLIENT:
BLACKMORES LIMITED

BLACKMORES

PROJECT:
V4 Blackmores General Meeting and Boardroom
POC & Reception Wall

TITLE:
Reception


SHEET SIZE:	SCALE:	DRAWN:	CHECKED:
A3	N/A	KB	VG

JOB NO.:
1448 & 1466

DRAWING NO.:
PAVS-AV-BGMD-LD-106

REV:
C

Blackmores Limited
Product Display

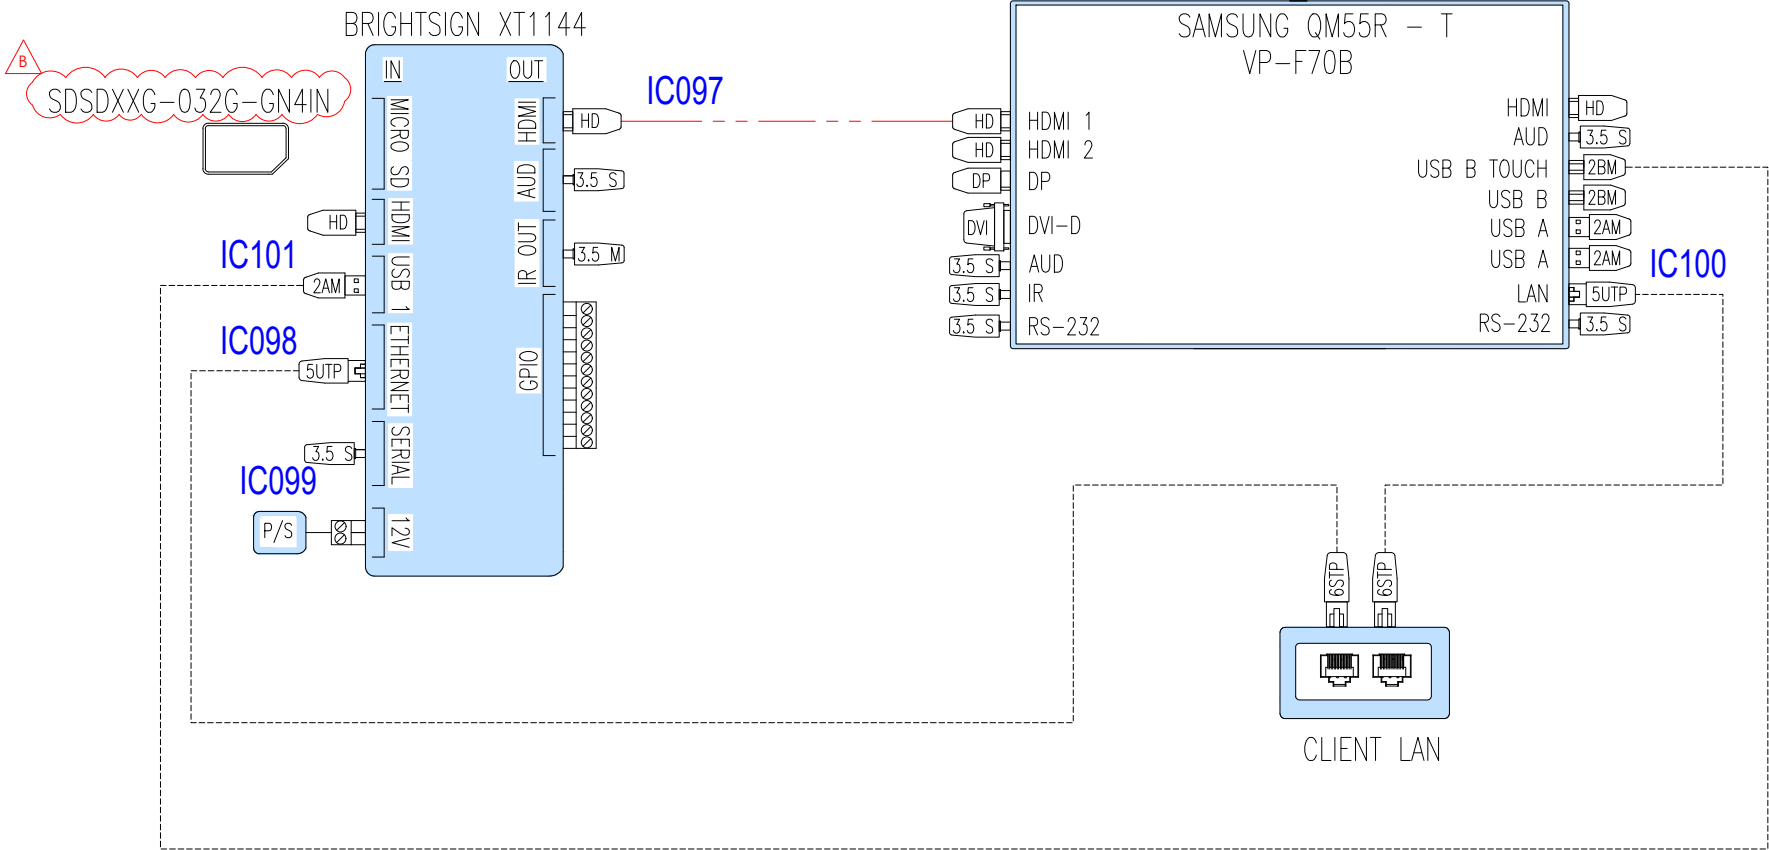

NOTES:

THE INFORMATION CONTAINED IN THIS DOCUMENT IS PROPRIETARY TO PRO AV SOLUTIONS (NSW) THIS DOCUMENT IS PREPARED FOR A SPECIFIC SITE AND INCORPORATES CALCULATIONS BASED ON DATA AVAILABLE AT THIS TIME. BY ACCEPTING AND USING THIS DOCUMENT, THE RECIPIENT AGREES TO PROTECT ITS CONTENTS FROM FURTHER DISSEMINATION, OTHER THAN THAT WITHIN THE ORGANIZATION NECESSARY TO EVALUATE SUCH SPECIFICATION) WITHOUT THE WRITTEN PERMISSION OF PRO AV SOLUTIONS (NSW) THE CONTENTS OF THIS DOCUMENT ARE NOT TO BE REPRODUCED OR COPIED IN WHOLE OR IN PART WITHOUT THE WRITTEN PERMISSION OF PRO AV SOLUTIONS (NSW).

B	04/04/22	For Construction Issue	KB
A	08/03/22	For Construction Issue	KB
REV	DATE	REVISION DESCRIPTION	DRAWN

STATUS:

FOR CONSTRUCTION

PRO AV SOLUTIONS
experience excellence

Unit 8, 25 Frenchs Forest Rd
Frenchs Forest
NSW 2086
Ph: (02) 8978 1700
Fax: (02) 9907 2077
www.proAVsolutions.com.au

CLIENT:
BLACKMORES LIMITED

BLACKMORES®

PROJECT:
V4 Blackmores General Meeting and Boardroom
POC & Reception Wall

TITLE:
Product Display



SHEET SIZE:	SCALE:	DRAWN:	CHECKED:
A3	N/A	KB	VG

JOB NO.:
1448 & 1466

DRAWING NO.:
PAVS-AV-BGMD-LD-107

REV:
B

Blackmores Limited
Meet & Eat

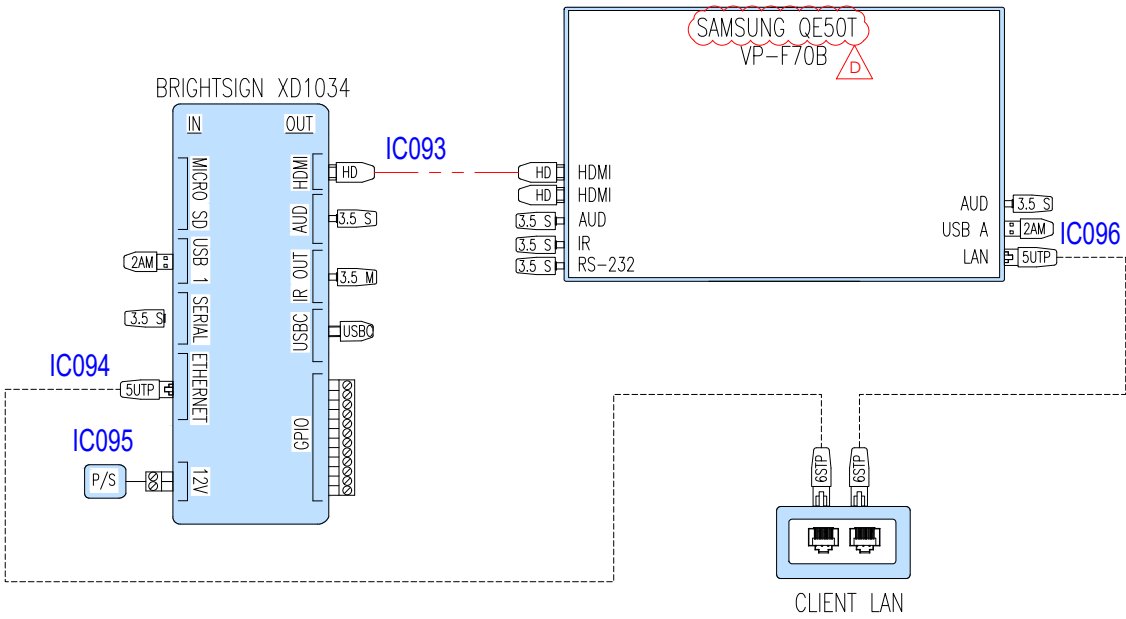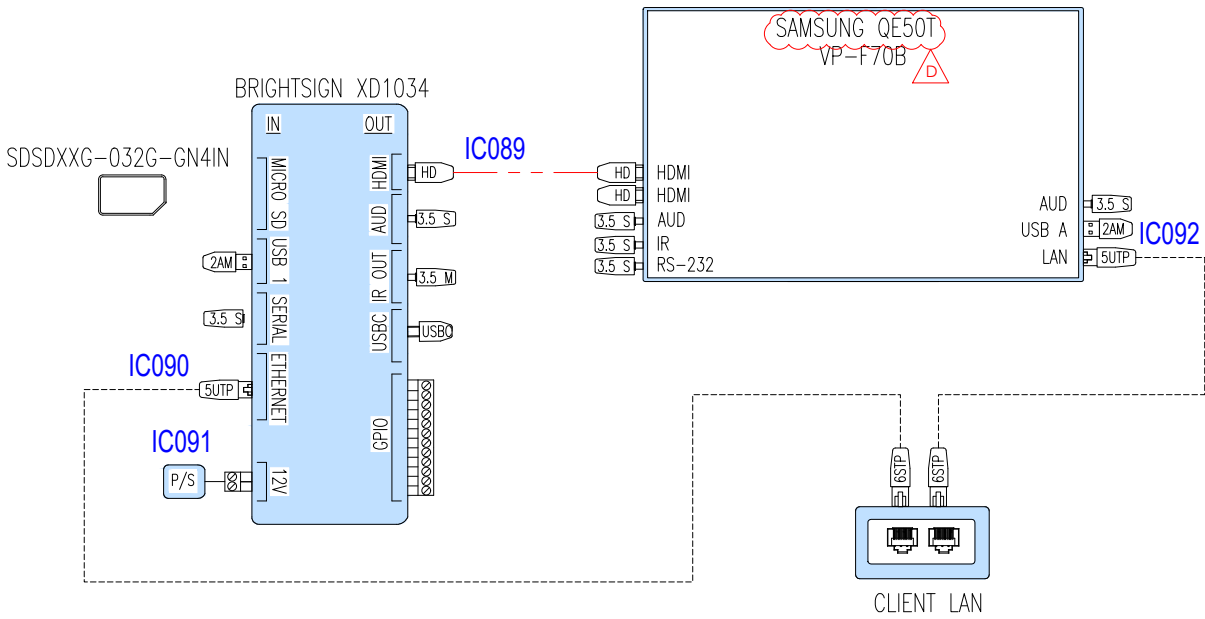

NOTES:

THE INFORMATION CONTAINED IN THIS DOCUMENT IS PROPRIETARY TO PRO AV SOLUTIONS (NSW) THIS DOCUMENT IS PREPARED FOR A SPECIFIC SITE AND INCORPORATES CALCULATIONS BASED ON DATA AVAILABLE AT THIS TIME. BY ACCEPTING AND USING THIS DOCUMENT, THE RECIPIENT AGREES TO PROTECT ITS CONTENTS FROM FURTHER DISSEMINATION, OTHER THAN THAT WITHIN THE ORGANIZATION NECESSARY TO EVALUATE SUCH SPECIFICATION) WITHOUT THE WRITTEN PERMISSION OF PRO AV SOLUTIONS (NSW) THE CONTENTS OF THIS DOCUMENT ARE NOT TO BE REPRODUCED OR COPIED IN WHOLE OR IN PART WITHOUT THE WRITTEN PERMISSION OF PRO AV SOLUTIONS (NSW).

D	21/04/22	For Construction Issue	BM
C	04/04/22	For Construction Issue	KB
B	28/03/22	For Construction Issue	KB
A	08/03/22	For Construction Issue	KB
REV	DATE	REVISION DESCRIPTION	DRAWN

STATUS:

FOR CONSTRUCTION



Unit 8, 25 Frenchs Forest Rd
Frenchs Forest
NSW 2086
Ph: (02) 8978 1700
Fax: (02) 9907 2077
www.proAVsolutions.com.au

CLIENT:

BLACKMORES LIMITED

PROJECT:

V4 Blackmores General Meeting and Boardroom
POC & Reception Wall

TITLE:

Meet & Eat

SHEET SIZE:	SCALE:	DRAWN:	CHECKED:
A3	N/A	KB	VG

JOB NO.:

1448 & 1466

DRAWING NO.:


PAVS-AV-BGMD-LD-108

REV:

D

Blackmores Limited
Comms Rack - AV Rack (Shared)

45 RU RACK (OFE)

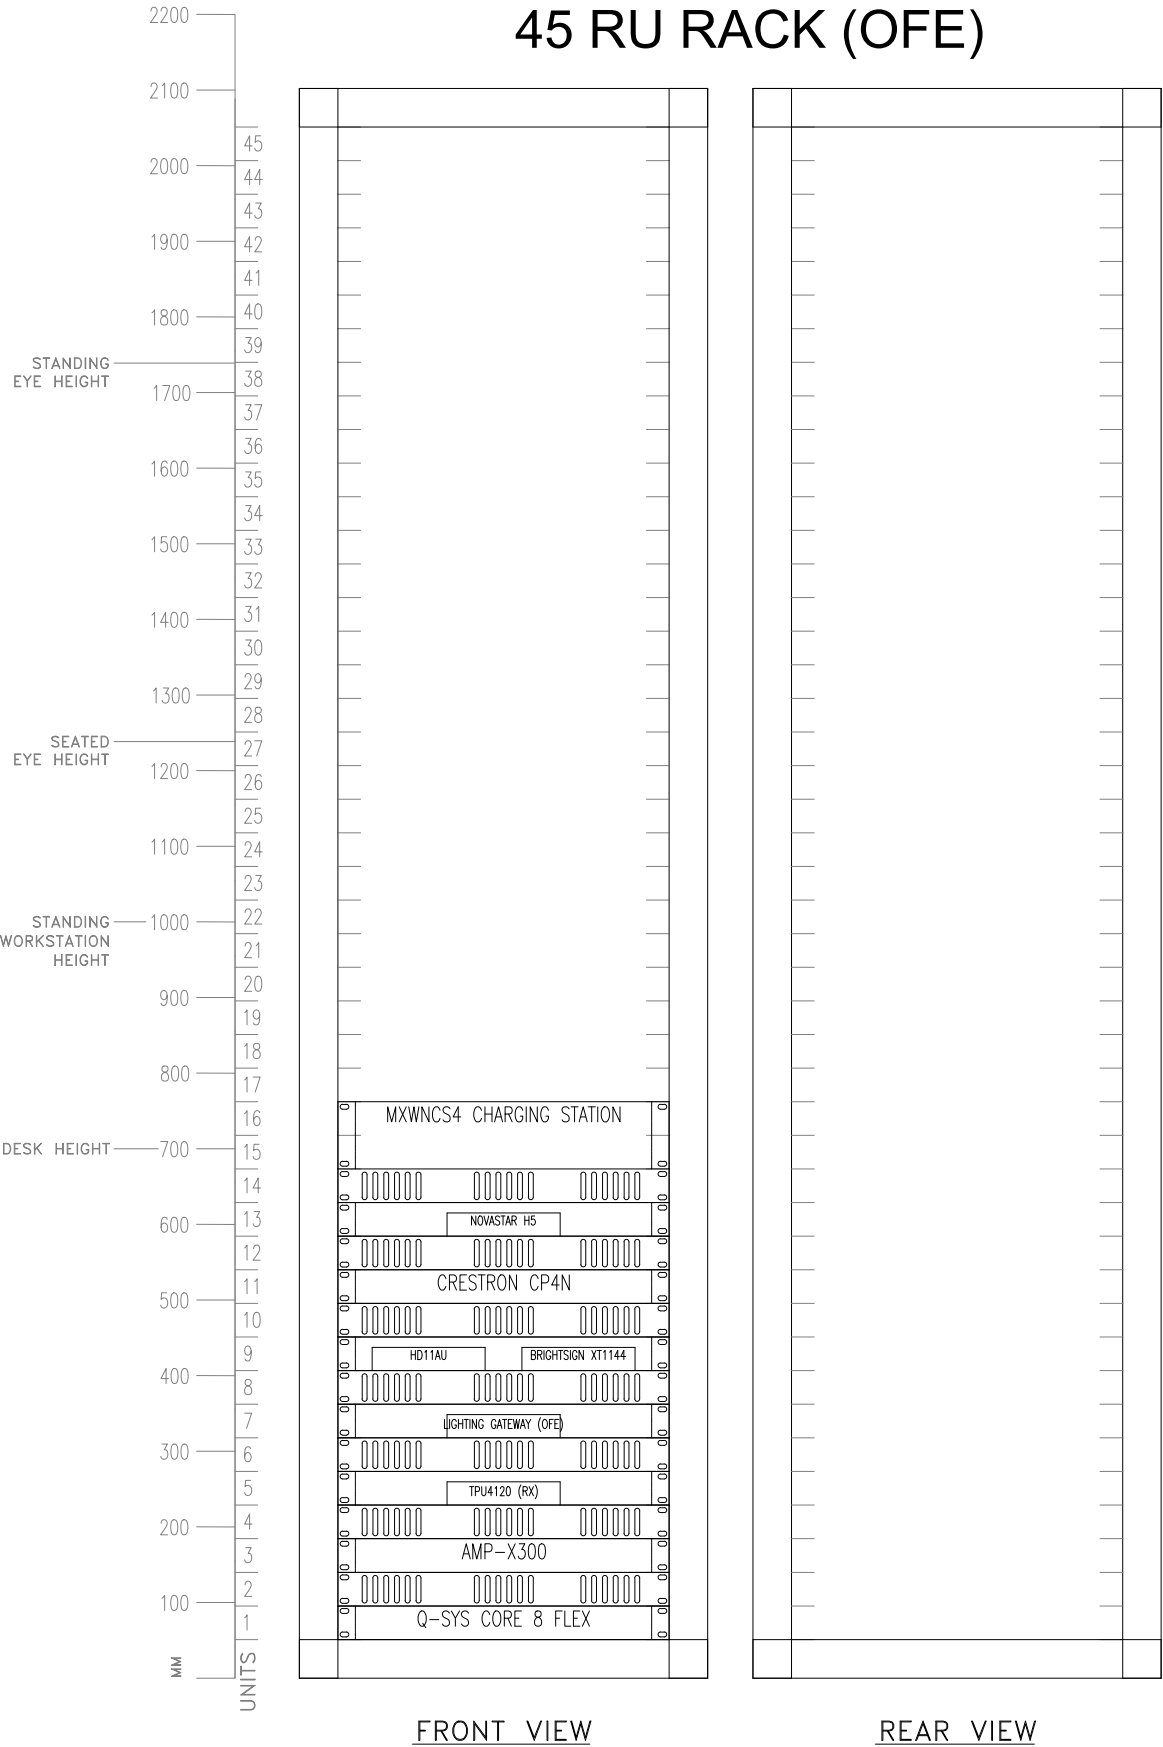

RESTRICTED SPACE	
CREDENZA	N
H<mm>	N/A
W<mm>	N/A
D<mm>	N/A
POWER LOAD	
10A	Y
15A	Y/N/NA
20A	Y/N/NA
BTU/hr:	
P _{actual} = 3.412141633 × P _{avg}	
RACK ACCESSORIES	
SIDES:	Y/N/NA
DOOR:	Y/N/NA
CASTORS:	Y/N/NA

ADD 8mm
ADD 16mm
ADD 72mm

NOTES:
THE INFORMATION CONTAINED IN THIS DOCUMENT IS PROPRIETARY TO PRO AV SOLUTIONS (NSW) THIS DOCUMENT IS PREPARED FOR A SPECIFIC SITE AND INCORPORATES CALCULATIONS BASED ON DATA AVAILABLE AT THIS TIME. BY ACCEPTING AND USING THIS DOCUMENT, THE RECIPIENT AGREES TO PROTECT ITS CONTENTS FROM FURTHER DISSEMINATION, OTHER THAN THAT WITHIN THE ORGANIZATION NECESSARY TO EVALUATE SUCH SPECIFICATION) WITHOUT THE WRITTEN PERMISSION OF PRO AV SOLUTIONS (NSW) THE CONTENTS OF THIS DOCUMENT ARE NOT TO BE REPRODUCED OR COPIED IN WHOLE OR IN PART WITHOUT THE WRITTEN PERMISSION OF PRO AV SOLUTIONS (NSW).

A	22/03/22	For Construction Issue	KB
REV	DATE	REVISION DESCRIPTION	DRAWN

STATUS:
FOR CONSTRUCTION



Unit 8, 25 Frenchs Forest Rd
Frenchs Forest
NSW 2086
Ph: (02) 8978 1700
Fax: (02) 9907 2077
www.proAVsolutions.com.au

CLIENT:
BLACKMORES LIMITED

BLACKMORES®

PROJECT:
V4 Blackmores General Meeting and Boardroom
POC & Reception Wall

TITLE:
Comms Rack - AV Rack (Shared)

SHEET SIZE:	SCALE:	DRAWN:	CHECKED:
A3	N/A	KB	VG
JOB NO.: 1448 & 1466			
DRAWING NO.: PAVS-AV-BGMD-LD-109			REV: A